
PROPOSED RESIDENTIAL BUILDING AT
LOT 201, OXFORD. MANCHESTER.


MODERNE DESIGN STUDIO
danman2580@gmail.com
(876) 870-2671

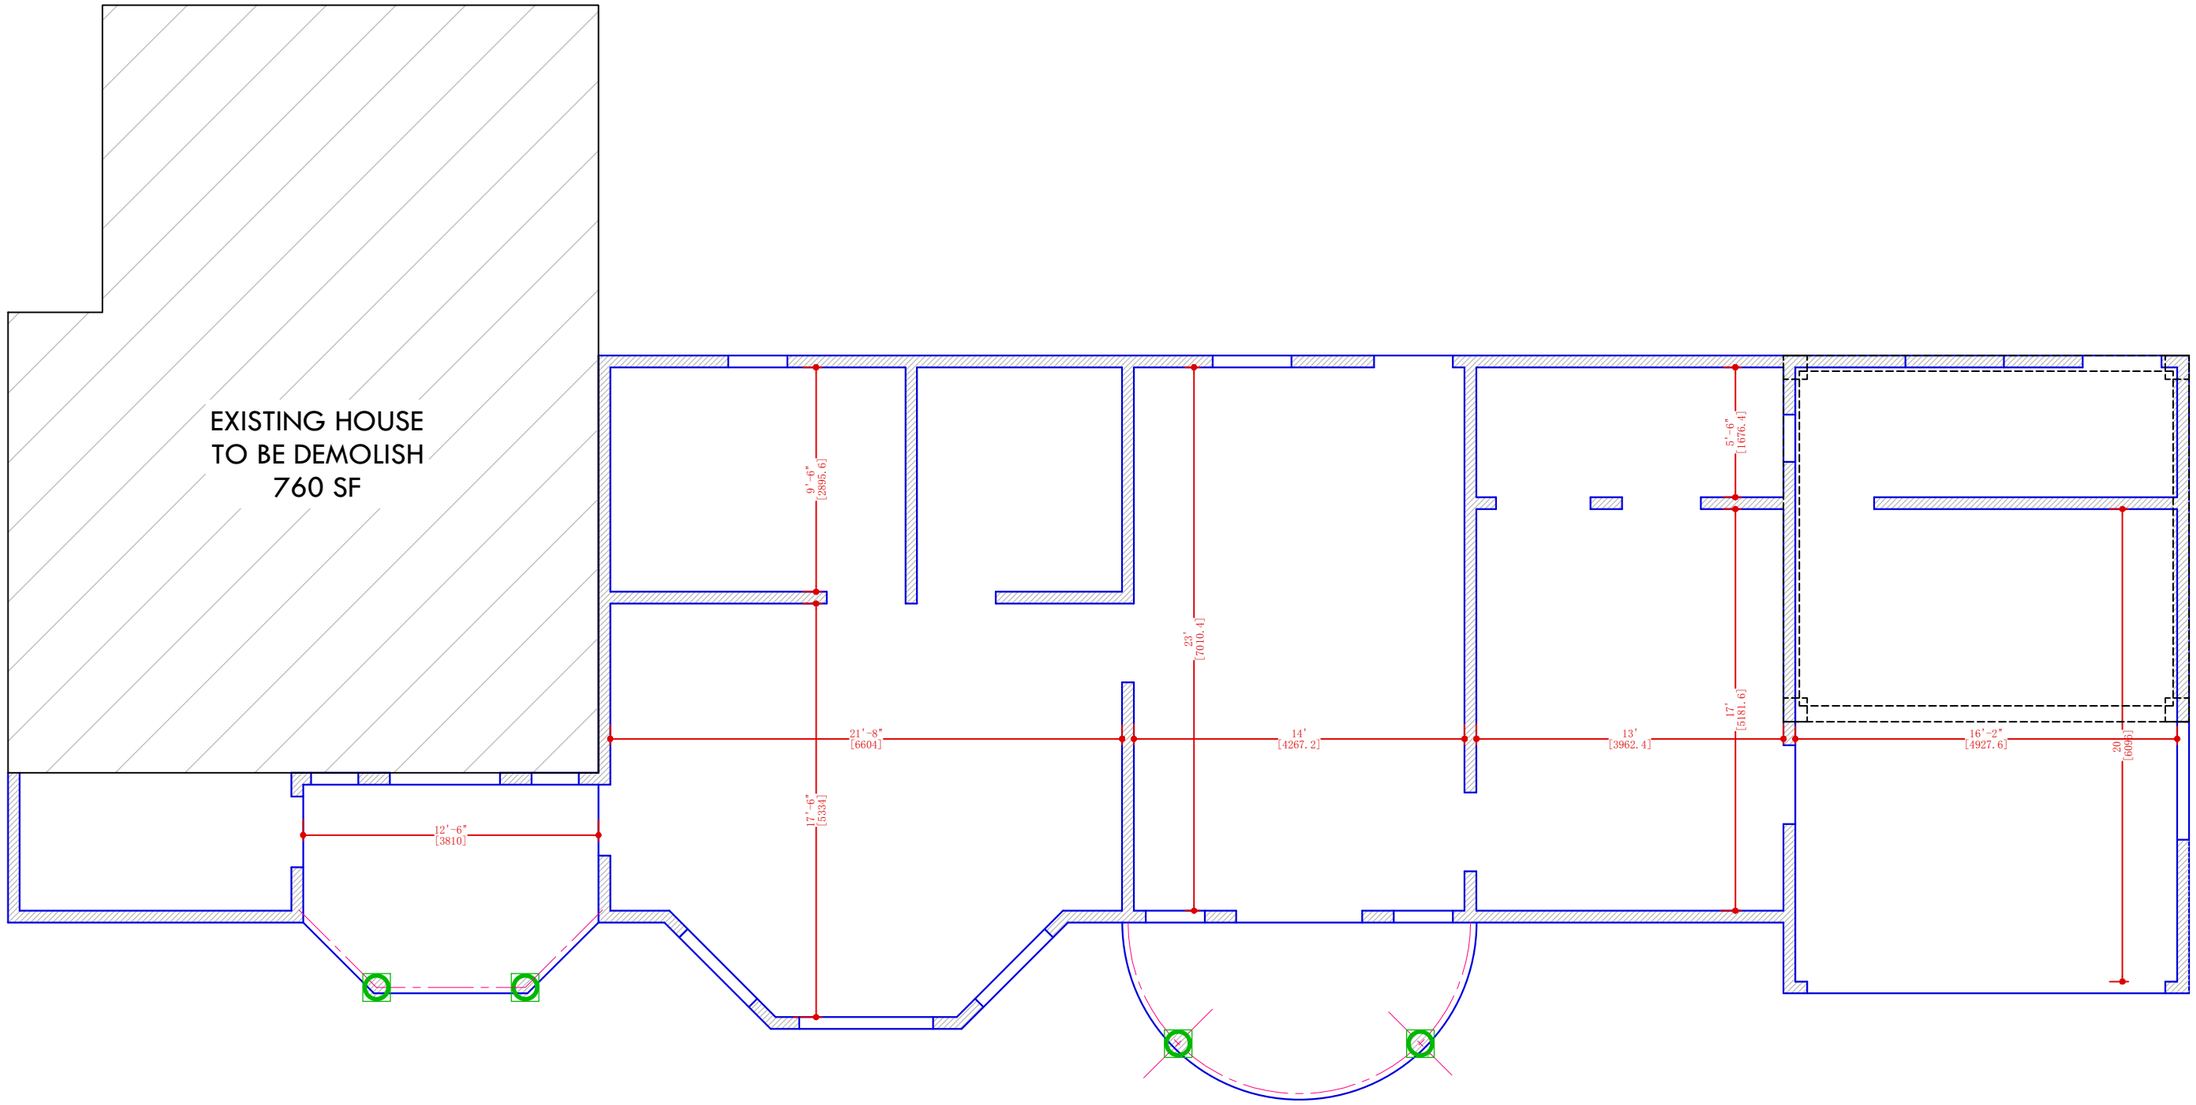

AS-BUILT STRUCTURE - 2,003 SF.

PROPOSED RESIDENTIAL BUILDING AT
LOT 201, OXFORD. MANCHESTER.


MODERNE DESIGN STUDIO
danman2580@gmail.com
(876) 870-2671

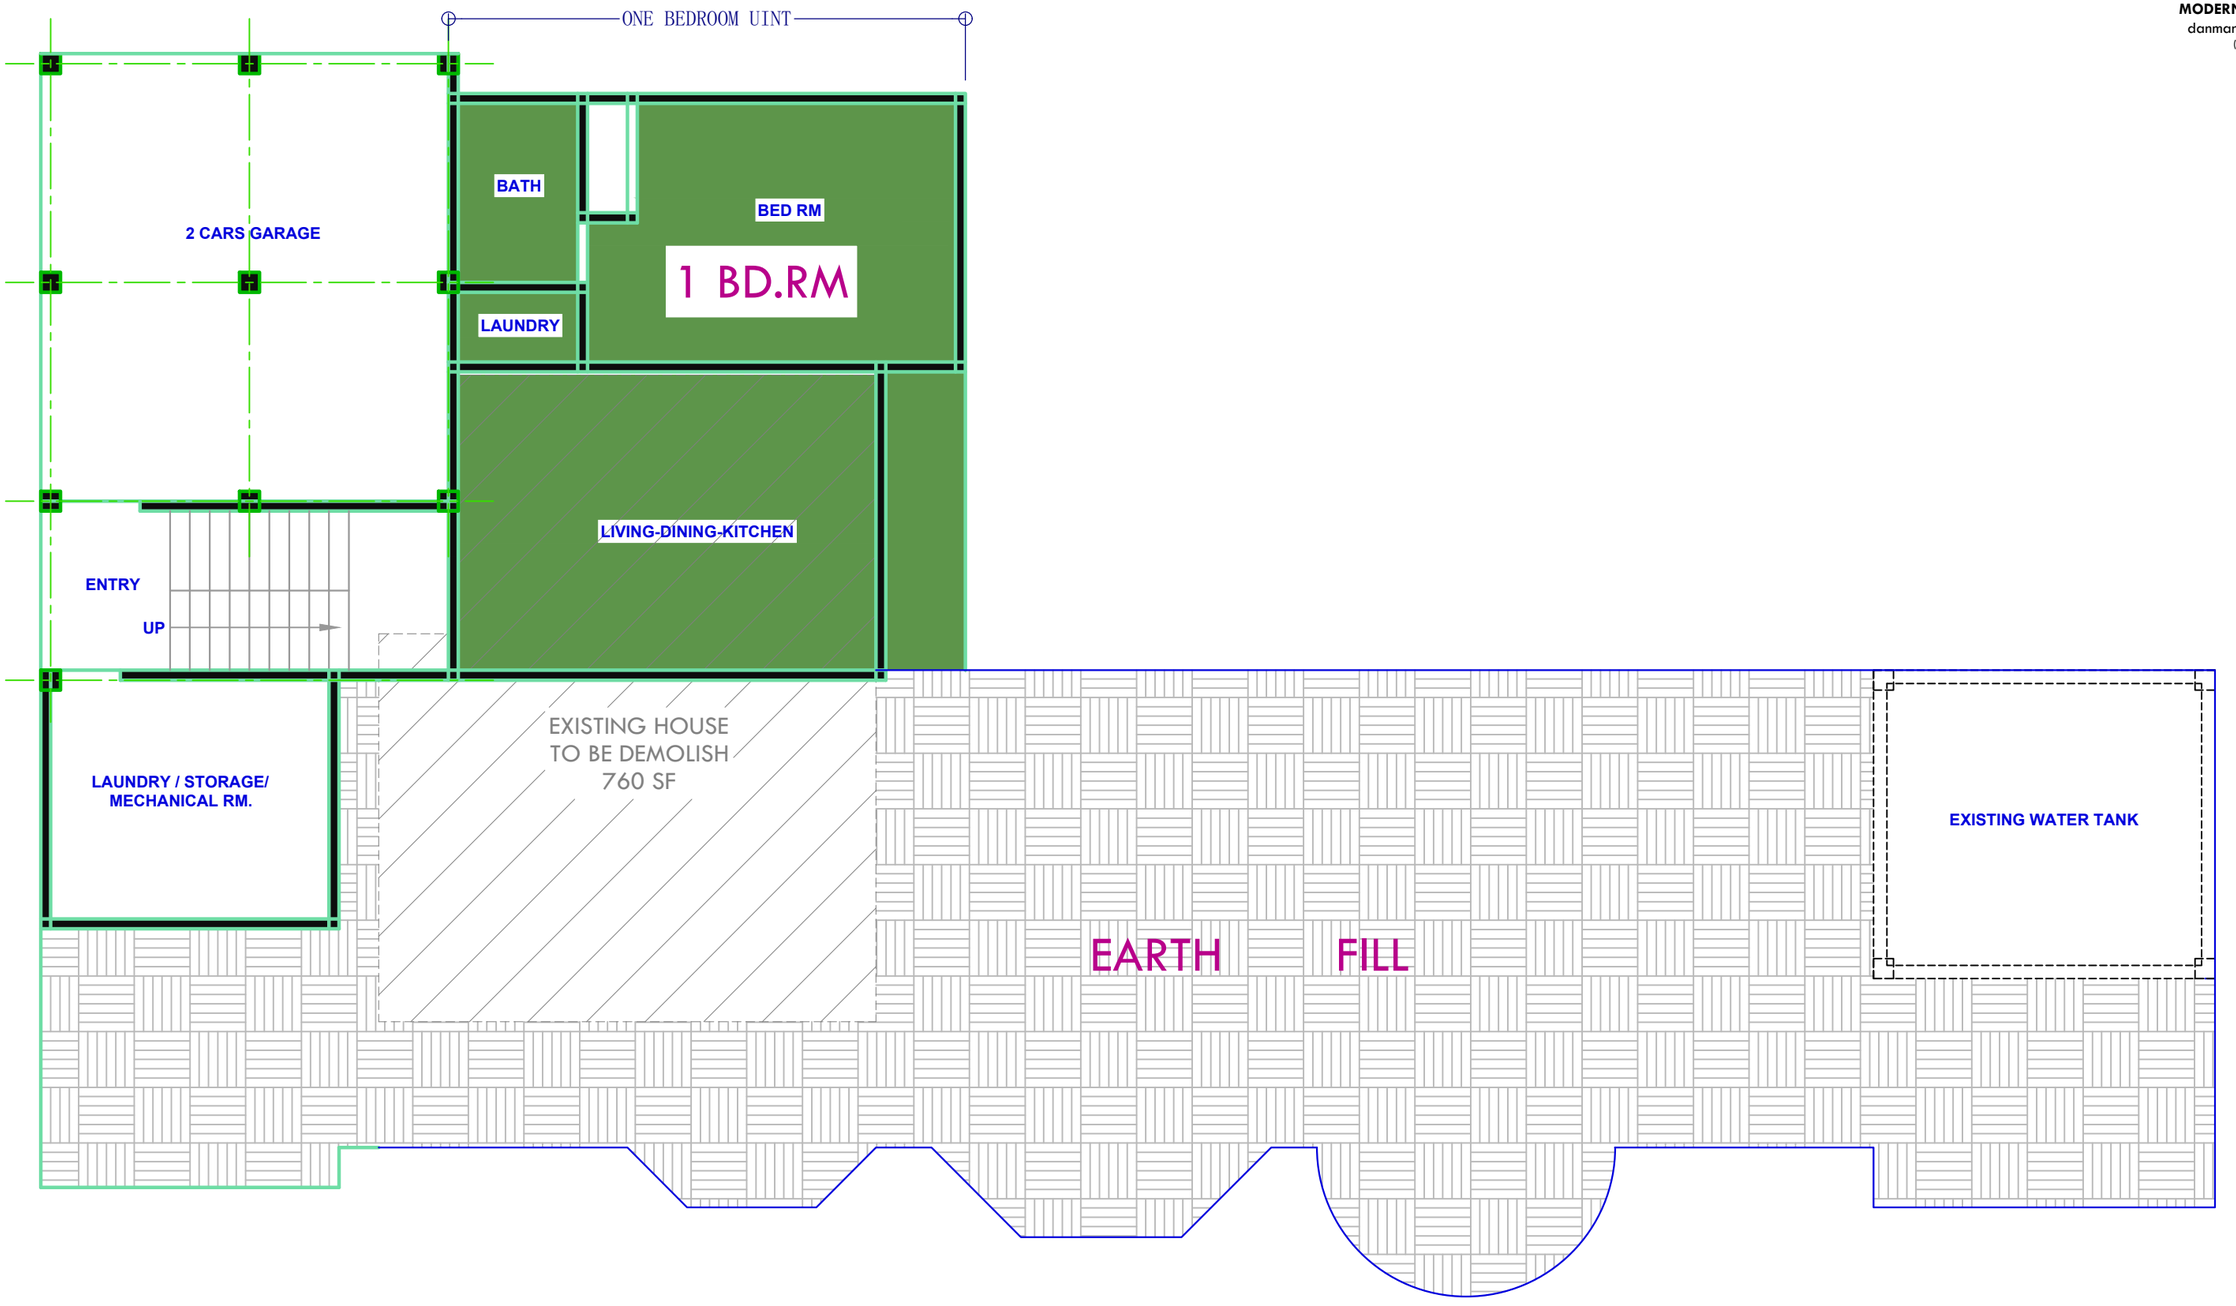

PROPOSED LOWER GROUND FLOOR

PROPOSED RESIDENTIAL BUILDING AT
LOT 201, OXFORD. MANCHESTER.

MODERNE DESIGN STUDIO
danman2580@gmail.com
(876) 870-2671

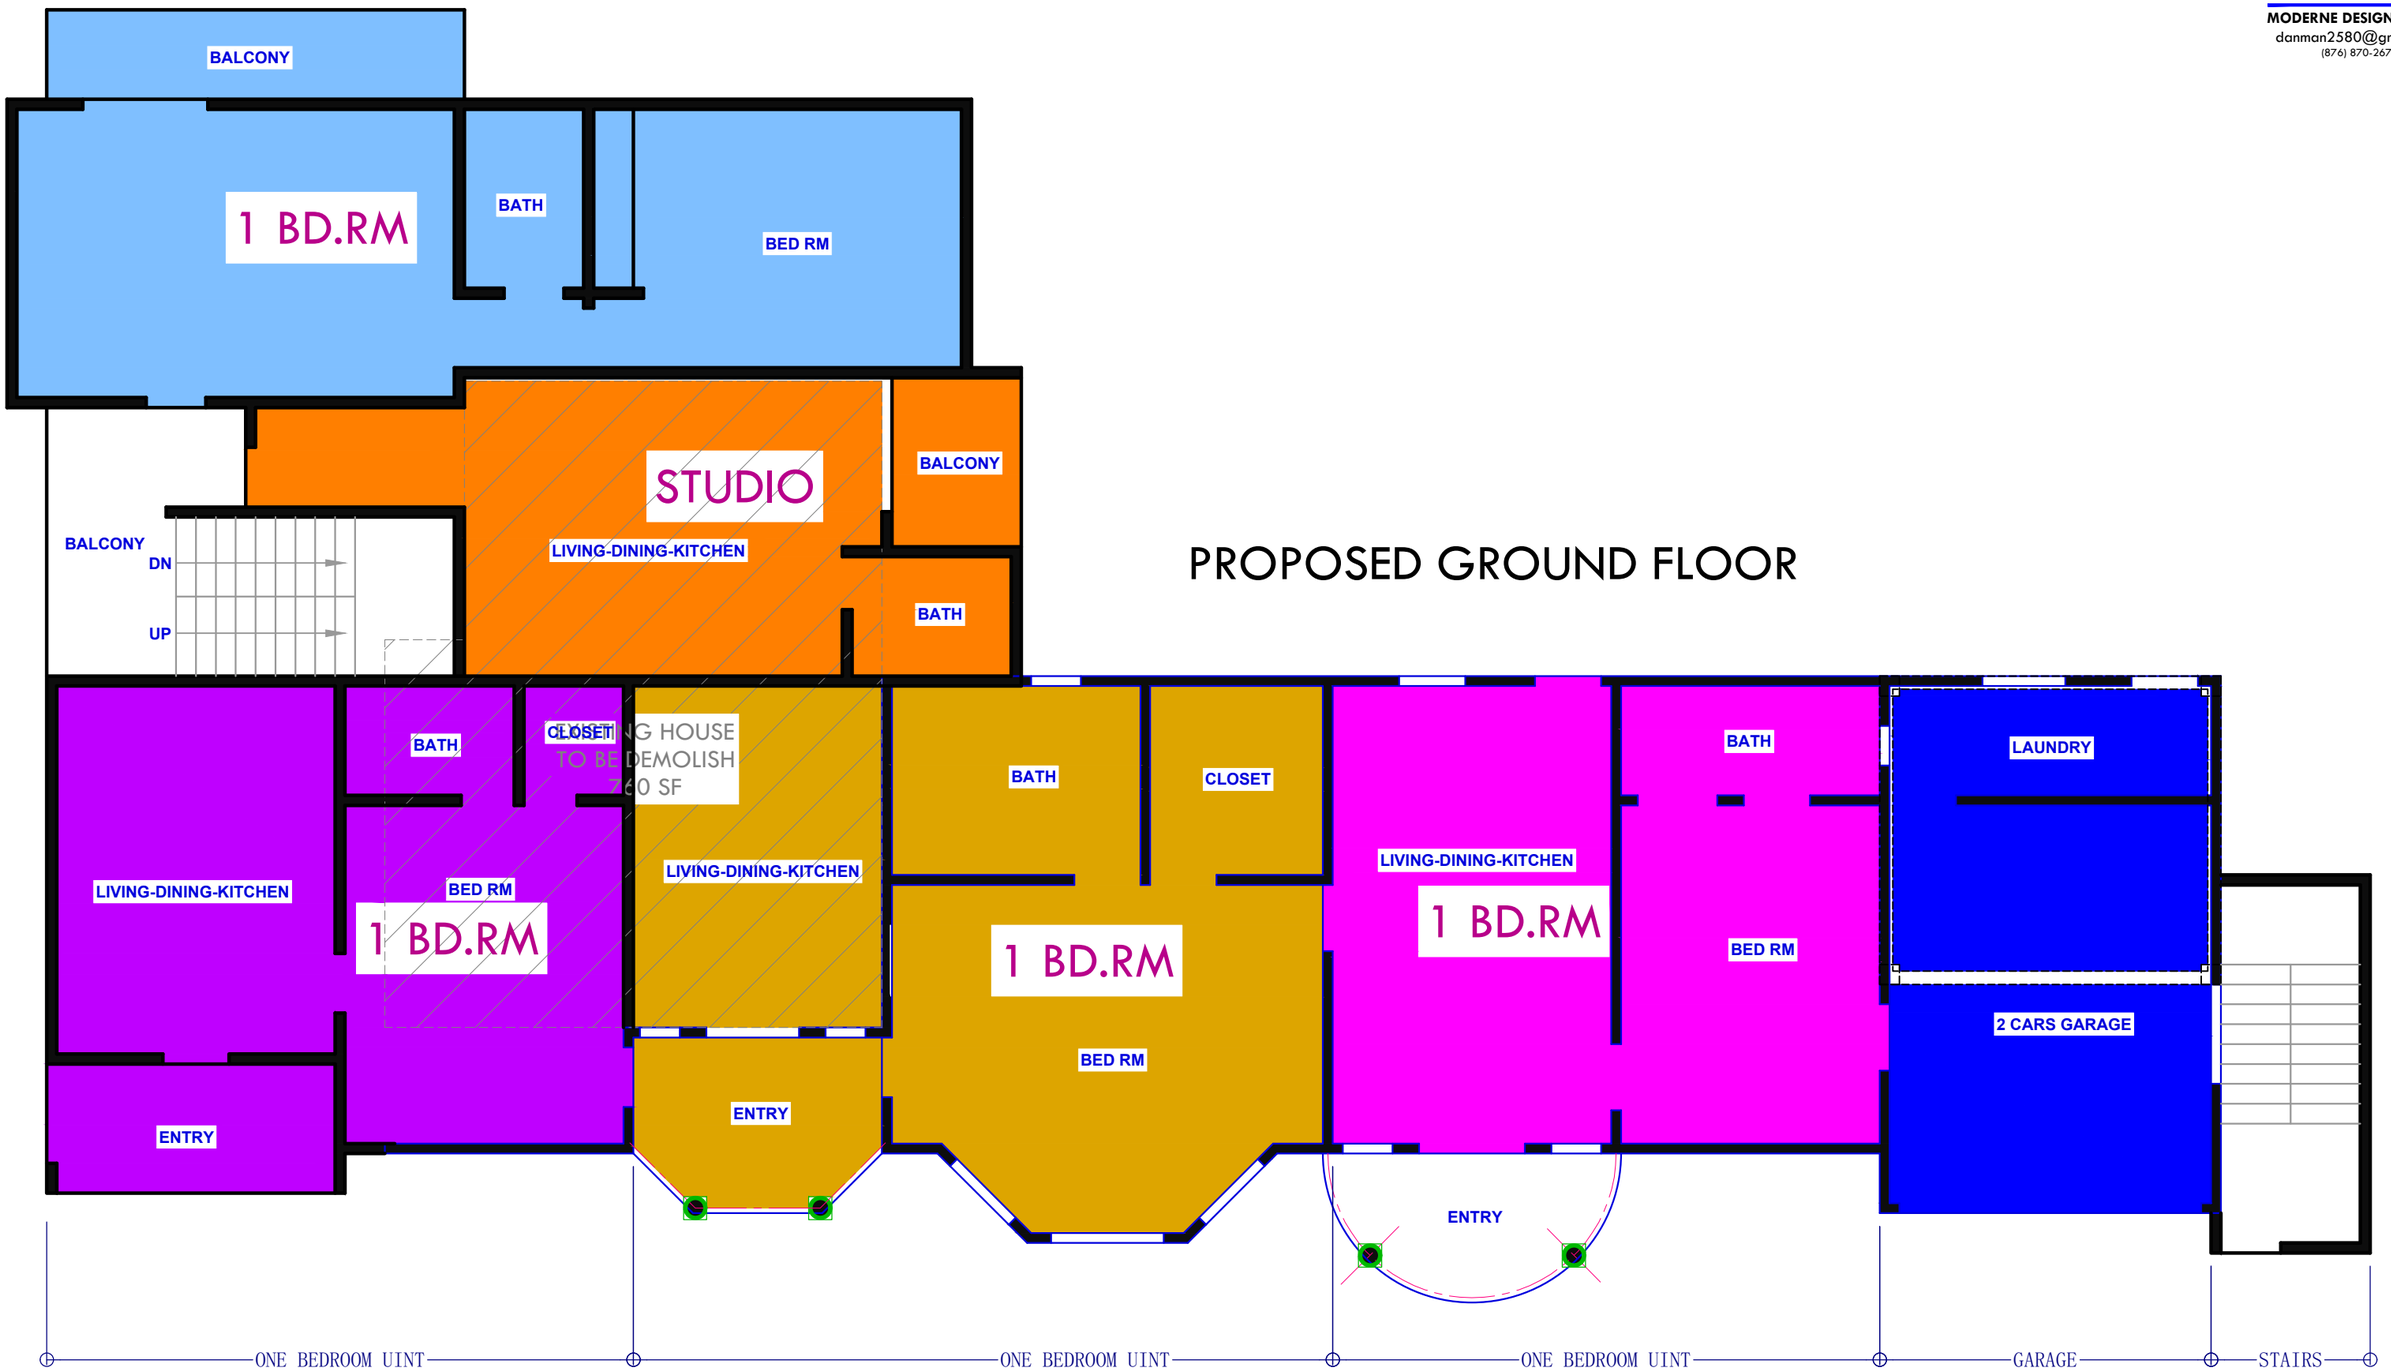

PROPOSED GROUND FLOOR

PROPOSED RESIDENTIAL BUILDING AT
LOT 201, OXFORD. MANCHESTER.

MODERNE DESIGN STUDIO
danman2580@gmail.com
(876) 870-2671

PROPOSED FIRST FLOOR

